

RESOLUTION
R 30-13

**RESOLUTION ACCEPTING PUBLIC WATER VALVE VAULT AT 717 E.
BUTTERFIELD ROAD IN LOMBARD, ILLINOIS**

WHEREAS, the Private Engineering Services Division of the Village of Lombard has certified the completion of the public water valve vault for the Chick-fil-A project at 717 E. Butterfield Road and has recommended that said improvement be accepted; and

WHEREAS, the Corporate Authorities concur with said recommendation.

NOW, THEREFORE, BE IT RESOLVED BY THE PRESIDENT AND BOARD OF TRUSTEES OF THE VILLAGE OF LOMBARD, DU PAGE COUNTY, ILLINOIS, AS FOLLOWS:

SECTION 1: That the public water valve vault for the Chick-Fil-A project at 717 E. Butterfield Road, as certified by the Private Engineering Services Division and as set forth on the approved engineering plans be and hereby is accepted for ownership by the Village of Lombard.

SECTION 2: That the on-site fire suppression line, storm sewer and sanitary sewer shall remain privately owned and maintained.


Adopted this 6th day of September, 2012,
pursuant to a roll call vote as follows:

Ayes: Trustees Gron, Giagnorio, Wilson, Breen, Fitzpatrick and Ware

Nays: None

Absent: None

Approved by me this 6th day of September, 2012.

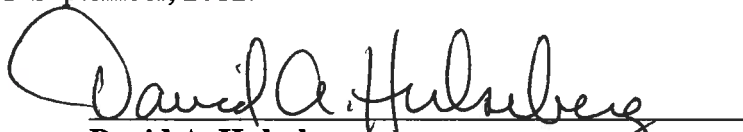

David A. Hulseberg
Village Manager

(Pursuant to the Authority Granted by the Village Board at the September 6, 2012 Village Board Meeting)

ATTEST:




Brigitte O'Brien
Village Clerk

**CERTIFICATE OF COMPLETION FOR PUBLIC WATER VALVE VAULT
FOR THE CHICK-FIL-A PROJECT AT 717 E. BUTTERFIELD ROAD**


We, as representatives of the Village of Lombard, certify that the public water valve vault that was constructed for the Chick-fil-A project at 717 E. Butterfield Road has been constructed substantially per plan.

We recommend acceptance by the Village President and the Board of Trustees of the Village of Lombard.


Recommended for acceptance:

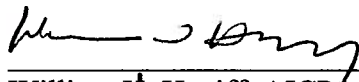

William H. Heniff, AICP
Director of Community Development

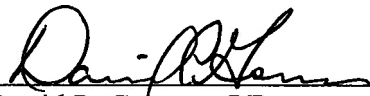

David P. Gorman, PE
Asst. Director of Public Works

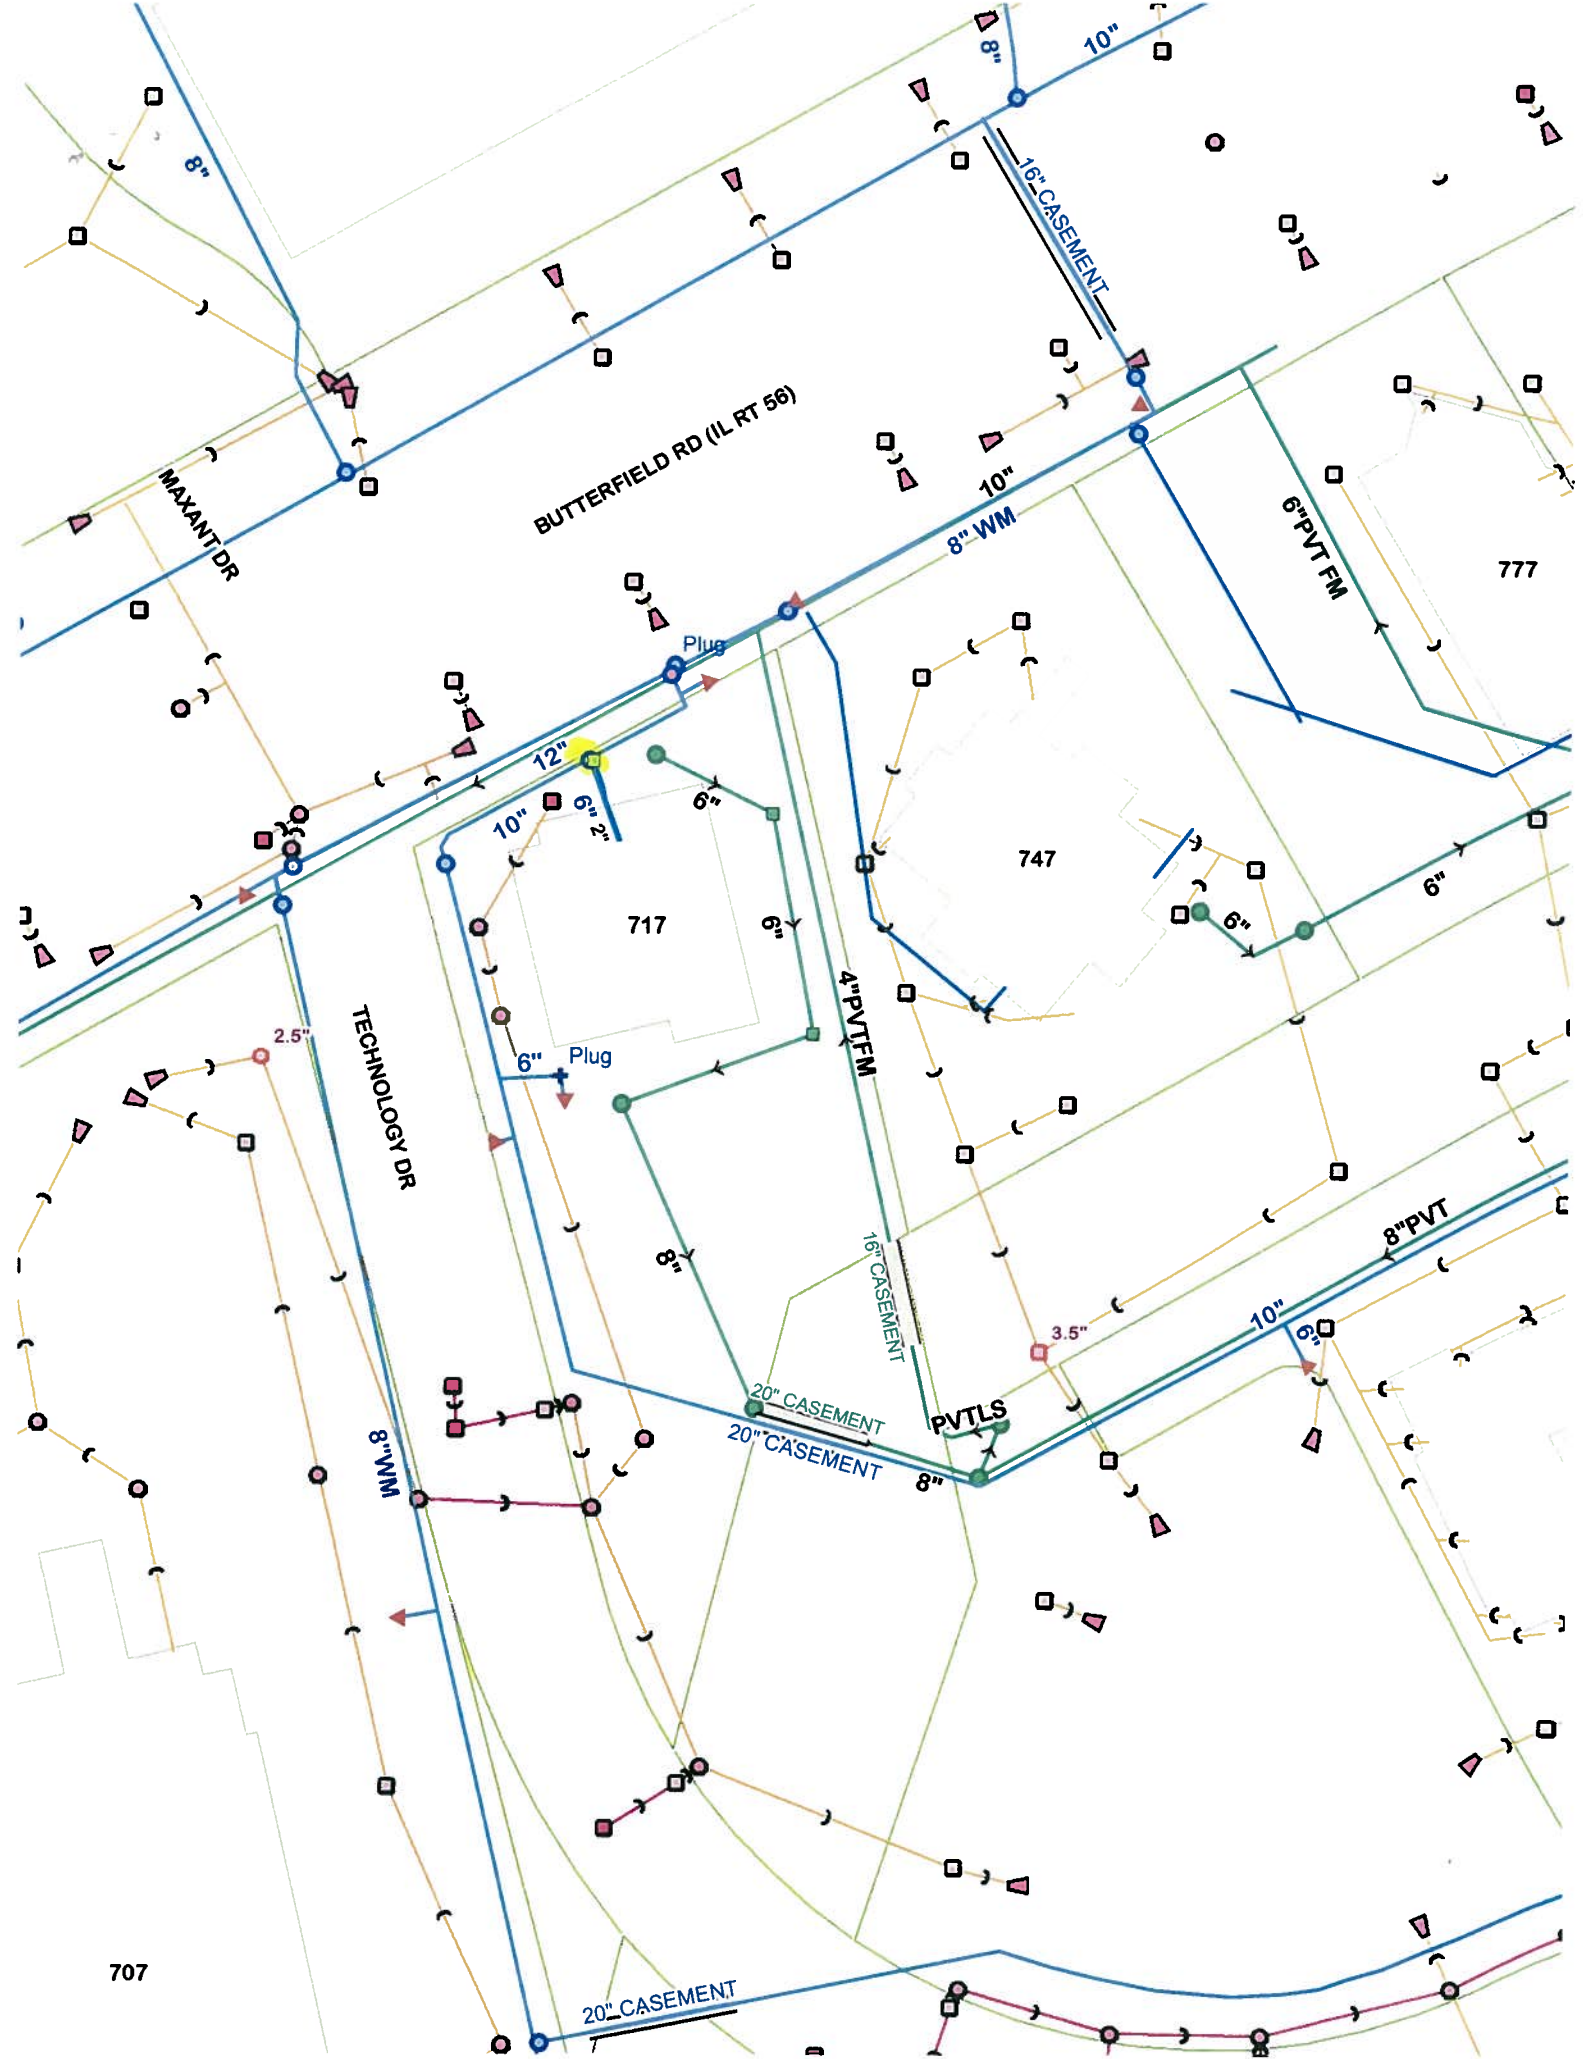

MAXANT DR

BUTTERFIELD RD (IL RT 56)

TECHNOLOGY DR

777

717

747

707

8"

10"

16" CASEMENT

10"

8" WM

6" PVT FM

Plug

12"

10"

6"

9"

4" PVT FM

6" Plug

2.5"

16" CASEMENT

20" CASEMENT

20" CASEMENT

PVTLS

8" PVT

10"

3.5"

8" WM

8"

20" CASEMENT